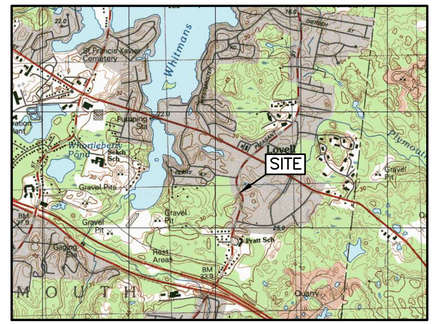

LOCUS MAP
SCALE IN FEET: 1"=1,500'

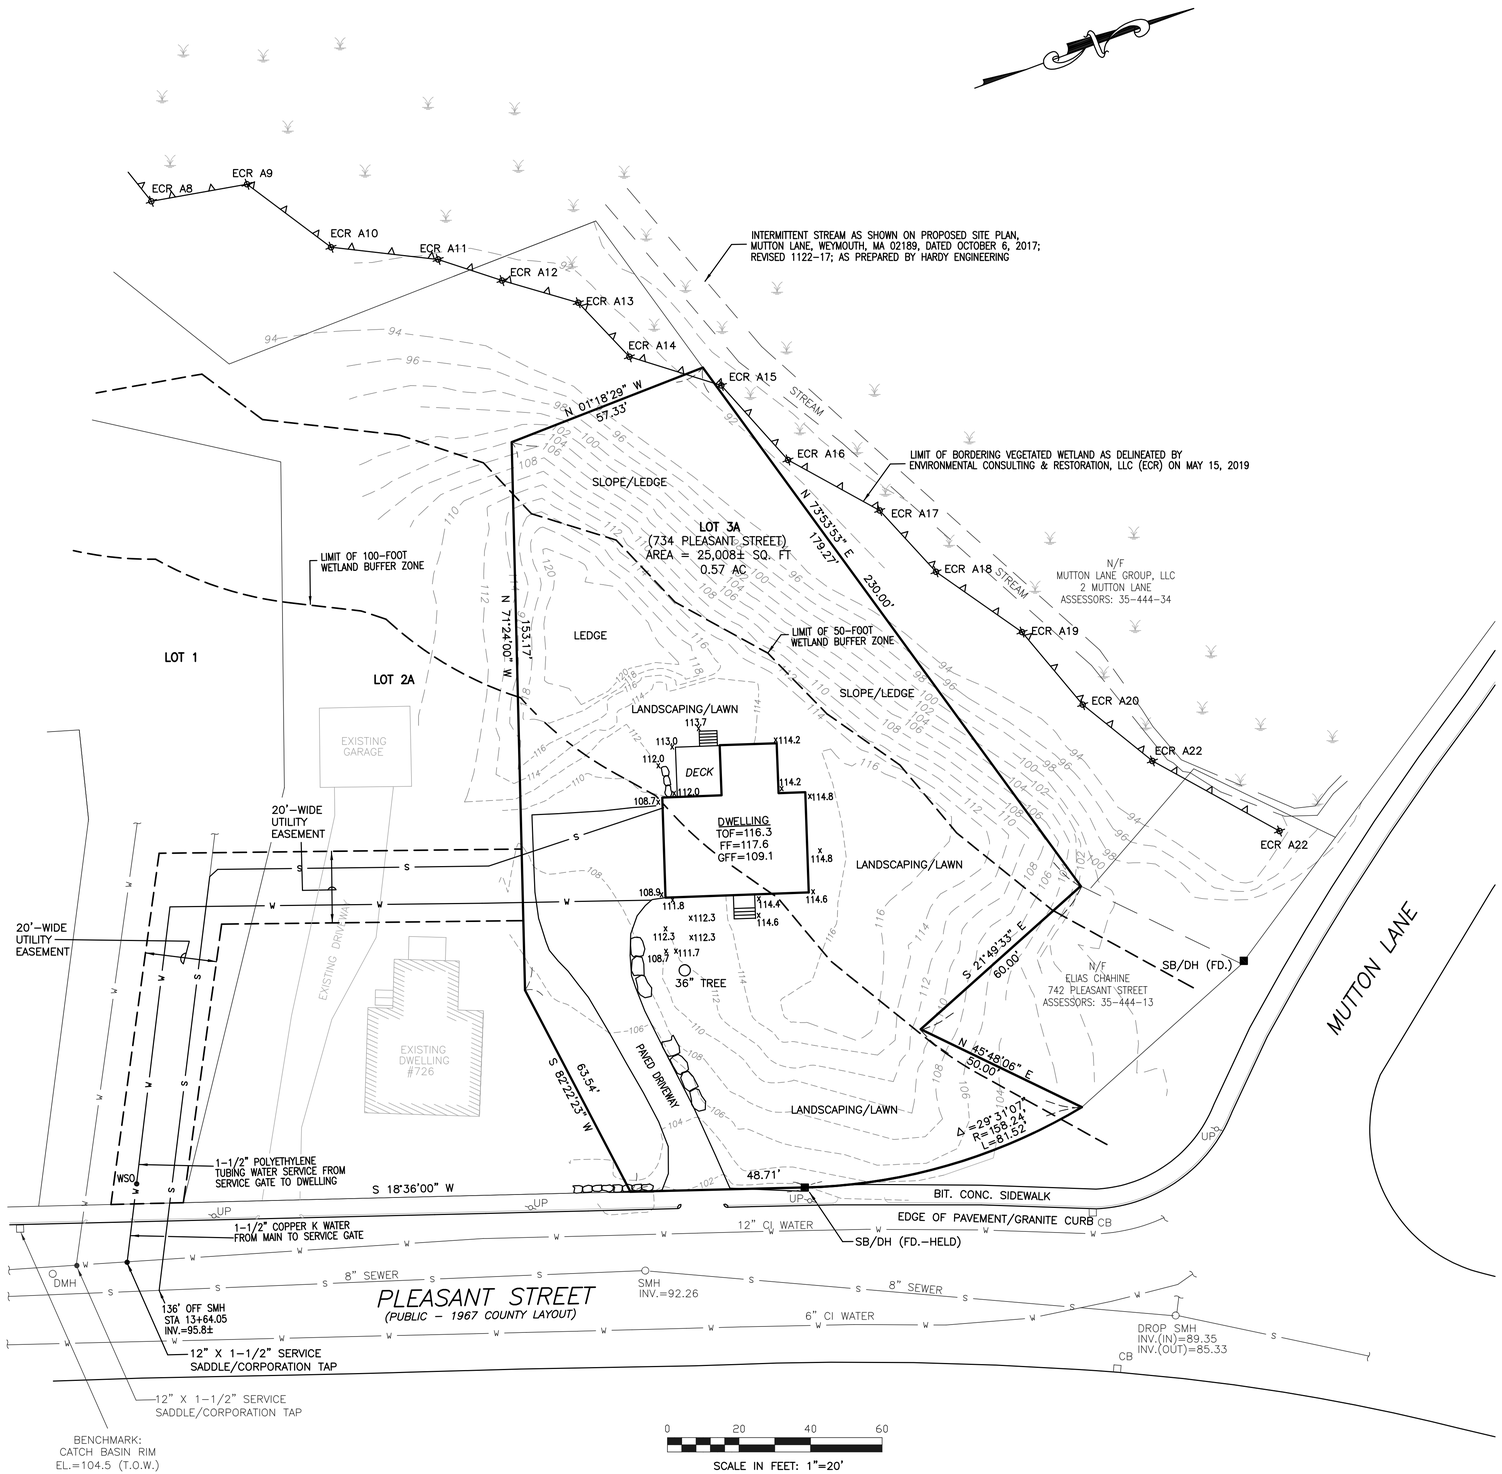

NOTES:

1. EXISTING PROPERTY LINE INFORMATION PROVIDED BY SITEC, INC.
2. AS-BUILT INFORMATION PROVIDED BY GLOBAL MAPPING ASSOCIATES.

JEFFREY A. DOLLOFF CIVIL No. 47069 REGISTERED PROFESSIONAL ENGINEER COMMONWEALTH OF MASSACHUSETTS

No.	Date	Revision Description	Chkd. by	Appvd. by

scale: 1"=20'
date: MAY 12, 2021
drawn: JAC
checked: ABT
approved: JAC
drawing number: AB-1

project: REQUEST FOR CERTIFICATE OF COMPLIANCE
734 PLEASANT STREET
WEYMOUTH, MASSACHUSETTS

client: RYDER DEVELOPMENT CORPORATION
741 BROAD STREET
WEYMOUTH, MASSACHUSETTS

drawing title: AS-BUILT SITE PLAN
(FOR WORK APPROVED IN ORDER OF CONDITIONS DEP FILE NO. 81-1247)

SITEC ENGINEERING, ENVIRONMENTAL & CONSULTANTS, INC.
769 Plain Street, Unit C
Marshfield, MA 02050
Tel. (781) 319-0100
Fax. (781) 834-4783

File No. SE18-1358